

TAX ID #213005 1-085 0000 OLD LOT

TAX ID #213005 1-045 0009 NEW LOT

SECTION 21, TOWNSHIP 30 N, RANGE 5 EAST, W.M.

WOODSIDE CHURCH  
ASBUILT C.B. & PIPE ELEVATIONS

STRUCTURE#	RIM ELEV.	TYPE\NOTE	INV. ELEV.	OUTLET ELEV.
CB#B	101.27	EXISTING	na.	99.50 to #4
CB#A	101.10	EXISTING	99.38 \ 99.29	99.28 to #5
CB#5(F)	101.56	TYPE 1-Field	98.61	98.61 to #4
CB#4	102.14	TYPE 1	98.84 \ 98.60	98.60 to #3
CB#3	101.52	TYPE 1 o/w	98.56	98.50 to #2
CB#7	101.66	TYPE 1	n.a.	99.93 to #6
CB#6	101.26	TYPE 1 o/w	98.94 x 2	98.94 to #2
CB#9	100.43	TYPE 1	99.09	99.01 to #6
CB#9(A)	100.52	TYPE 1-Added	n.a.	99.46 to #9
CB#2	100.93	TYPE 1 o/w	98.54 \ 98.46	98.41 to bioswale
CB#11(F)	100.47	TYPE 1 Field Infiltration, o/w	97.87	97.87 to infiltration

NOTES:

Bioswale, inlet elev. 98.32  
bottom elev. 96.70  
outlet elev. 97.53

Detention inlet elev. 96.92  
bottom elev. 96.75  
outlet elev. 97.89...pond will hold 1.14 ft. of water before flowing into infiltration trench

PIPE DATA TABLE

PIPE #	DIA	LENGTH	SLOPE
P6	12" C/PEP	30.73	0.10%
P5	12" C/PEP	74.35	0.11%
P4	12" C/PEP	171.41	0.11%
P3	12" C/PEP	147.20	0.11%
P2	12" C/PEP	18.55	0.22%
P1	12" C/PEP	34.30	1.46%
P8	8" C/PEP	147.41	0.88%
P7	12" C/PEP	77.83	0.59%
P10	8" C/PEP	174.53	0.14%
P11	8" C/PEP	31.81	1.57%

CB ELEVATIONS & LOCATES

CB no.	Rim Elev	Inv Elev	Locate CB at:	Remarks:
#B	100.89	98.68		Existing
#A	100.50	98.50		Existing
5	101.30	98.47	Sta 6+71.0	Type 1
4	101.80	98.39	Sta 6+71.0, 77.0 left	Type 1
3	101.50	98.20	Sta 4+92.45, 77.0 left	Type 1
2	100.60	98.04	Sta 3+45.20, 77.0 left	Type 1
7	101.40	99.40	Sta 4+92.45 on Profile	Type 1
6	100.90	98.50	Sta 3+45.20 on Profile	Type 1
9	100.20	98.73	Sta 1+69.88 on Profile	Type 1

OWNER:

WOODSIDE NEW LIFE ASSEMBLY  
9015 44TH DR NE  
MARYSVILLE, WA 98272  
PASTOR RICARDO QUINTANA  
PHONE: 360-659-0445

EROSION CONTROL ENGINEER:

DEAN HOUGH & ASSOCIATES  
8918 11TH ST NE  
EVERETT, WA 98205-1407  
PHONE: 425-335-0262

NOTE:  
Issuance of a building permit in accordance with these plans does not obligate Snohomish County in any way to insure the correct location in the field of buildings, structures, parking areas, landscaping, and other features as contained in this plan. The owner/permit holder is responsible for the correct field location of these features relative to any required setbacks, easements, buffers or other limits as shown on these plans and/or included with any and all agreements, contracts, etc. associated with this building plan.

SUMMARY OF DATA

EXISTING ZONING: R7200  
BUILDING FOOTPRINT: MAIN CENTER 21,210 SF  
GATEHOUSE CENTER 2,700 SF  
STORAGE SHEDS 675 SF  
TOTAL 24,585 SF  
TOTAL SITE AREA: 137,007 SF (3.14 ACRES)  
SITE COVERAGE: 24,585/137,007 = 17.9%  
PARKING: STANDARD STALLS: 69 EA.  
COMPACT STALLS: 61 EA.  
HANDICAP STALLS: 4 EA.  
TOTAL PARKING STALLS: 134 EA.  
TOTAL ASPHALT=71,500 SF  
TOTAL LANDSCAPE AREA=10,210 SF



VICINITY MAP


1" = 2000'

LEGEND:

- EXIST. SHRUBBRY, 6' HIGH PLUS EVERGREEN TREE
- DECIDUOUS TREE, SIZE SHOWN(DIA)
- PLANNED PROPERTY CORNER (UNSURVEYED CORNER)
- DOWNSPOUT
- NEW CONTOUR LINES
- CLEARING LIMIT LINE
- 2' REFERENCE POINT TO R/W LINE
- NEW W. NEW WATER MAIN OR SERVICE
- NEW S.S. NEW SAN. SEWER MAIN OR SERVICE
- EX. W. EX. WATER MAIN OR SERVICE
- EX. S.S. EX. SAN. SEWER MAIN OR SERVICE
- C.O. NEW S.S. CLEANOUT
- 0.50 FG = 100.50' FINISHED GRADE ELEVATION

CONSTRUCTION NOTES:

- Install 6 luminaires at the locations shown hereon with light shields shielding adjacent residences. See additional notes on sht 2 of 3.
- During paving operations Contractor shall pave per section A-A as shown on this plan. Also an 8' wide paved shoulder shall be laid in the location shown along site frontage with tapering edges as shown with a stripped paved access walk 44" wide from the new shoulder and parallel to the access drive making a total paved width of 28.75' to the pilot house as shown.
- All islands shall be surrounded with extruded curbing 6" wide x 6" high to protect the landscaping in the islands.
- Strip stall demarcationlines, arrows, the access route of travel, and the handicap symbol as shown with durable plastic 6" wide striping.

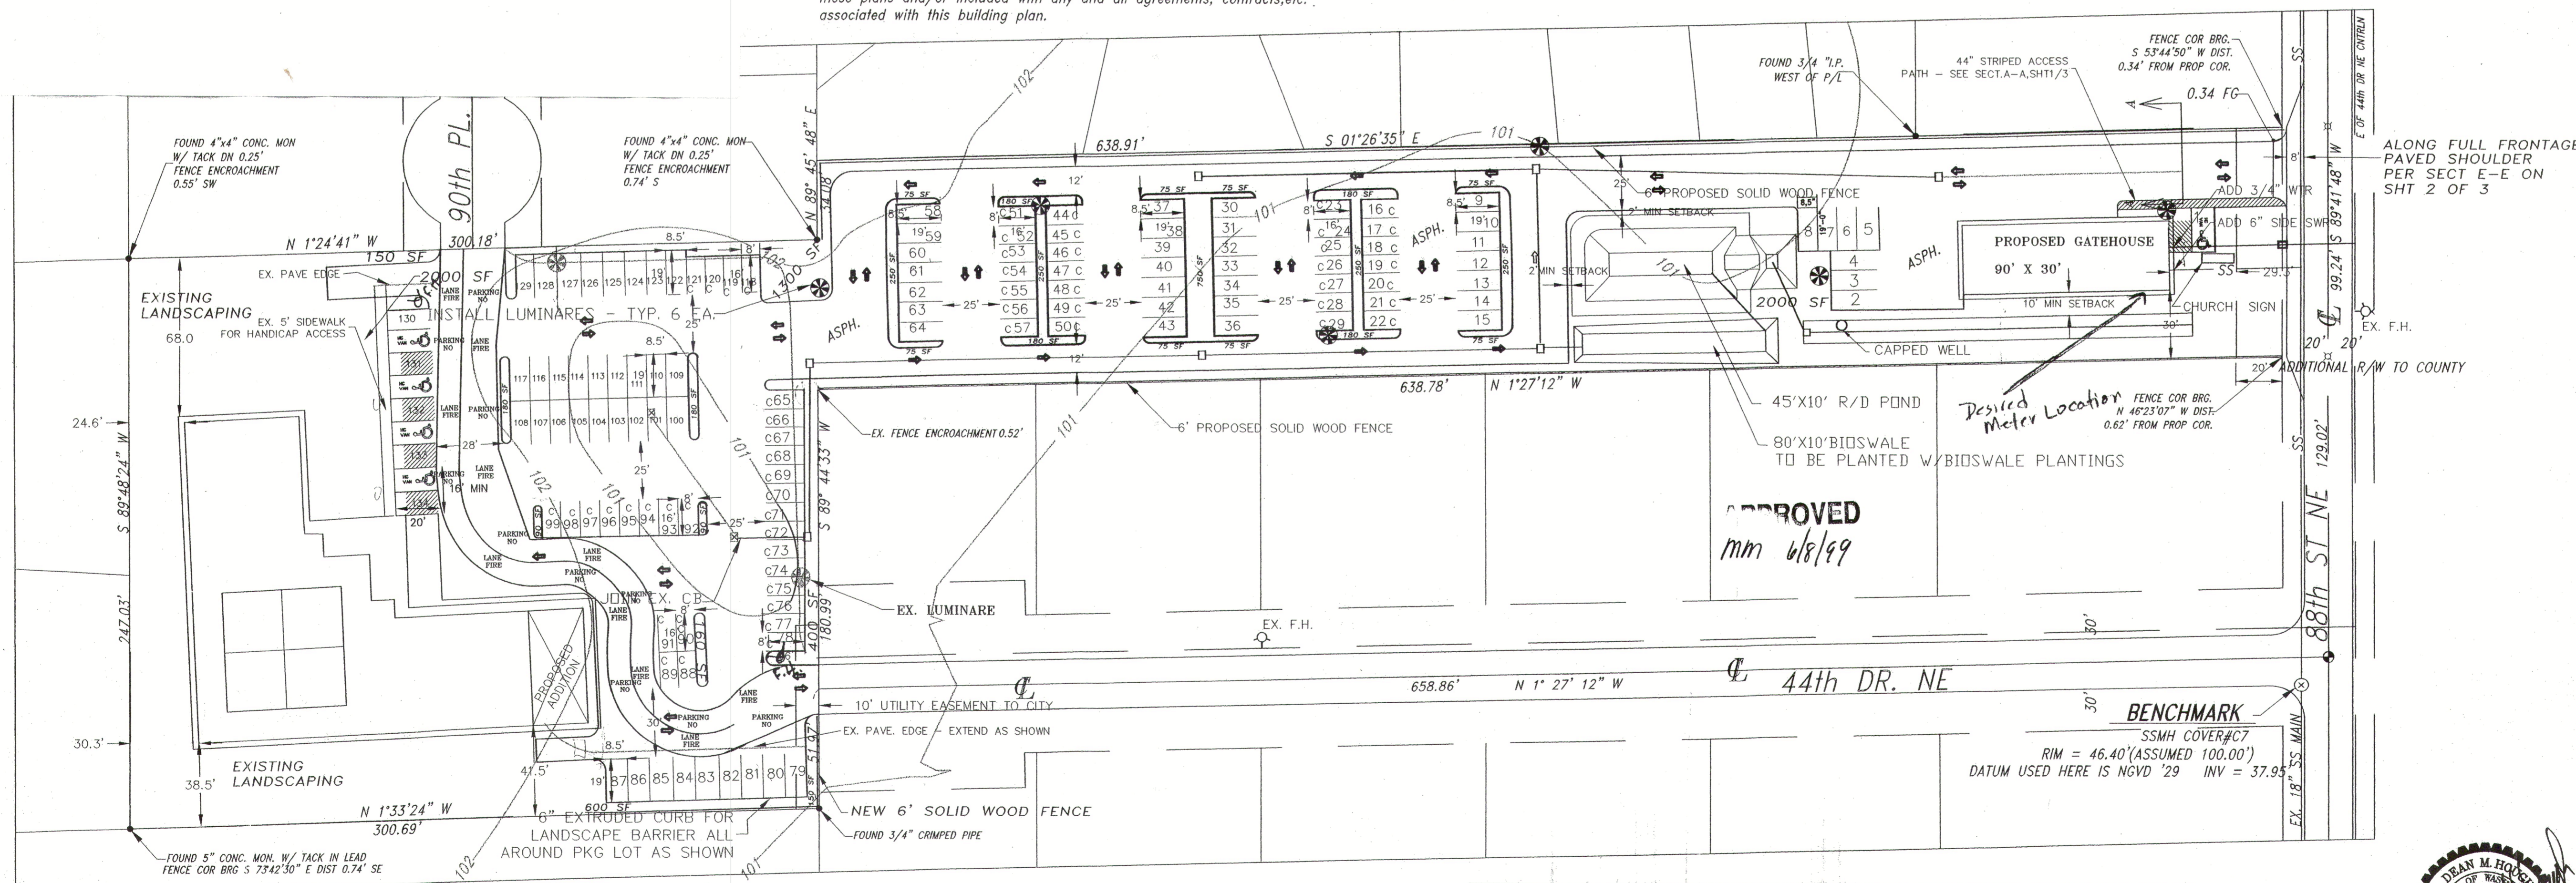


SITE PLAN

SCALE: 1" = 40'-0"

SNOHOMISH COUNTY PLANNING AND DEVELOPMENT SERVICES  
APPROVED FOR CONSTRUCTION

BY: *Paul R. Slight* 6/15/99  
R/W permit number: 99105331

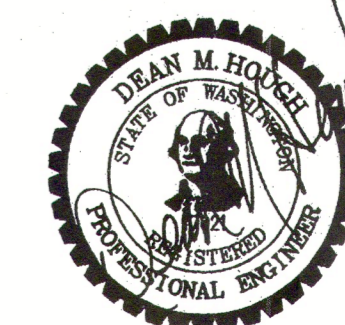

EXPIRES 4/5/00

General Notes

MAJOR C. U. REVISION SITE PLAN  
WOODSIDE N. L. A. PFN 98-109890  
9015 44th DR. NE

No.	Revision/Issue	Date
2	SECOND CORRECTIONS	4/29/99
1	FIRST CORRECTIONS	1/99

Firm Name and Address  
DEAN HOUGH & ASSOCIATES  
8918 11TH ST NE  
EVERETT, WA 98205-1407  
PHONE 425-335-0262  
DRAWN BY: D S HOUGH

Project Name and Address  
SNO. CTY. F # 98-109890  
9015 44th DR. NE  
MARYSVILLE WA 98272

Date  
JULY 14, 1998

Scale  
1 IN = 40 FEET

Project: WOODSIDE N. L. A. PFN 98-109890  
C. U. REVIS. PROJ. 1/4

MAY 13 1999

WOODNLASB.DWG

